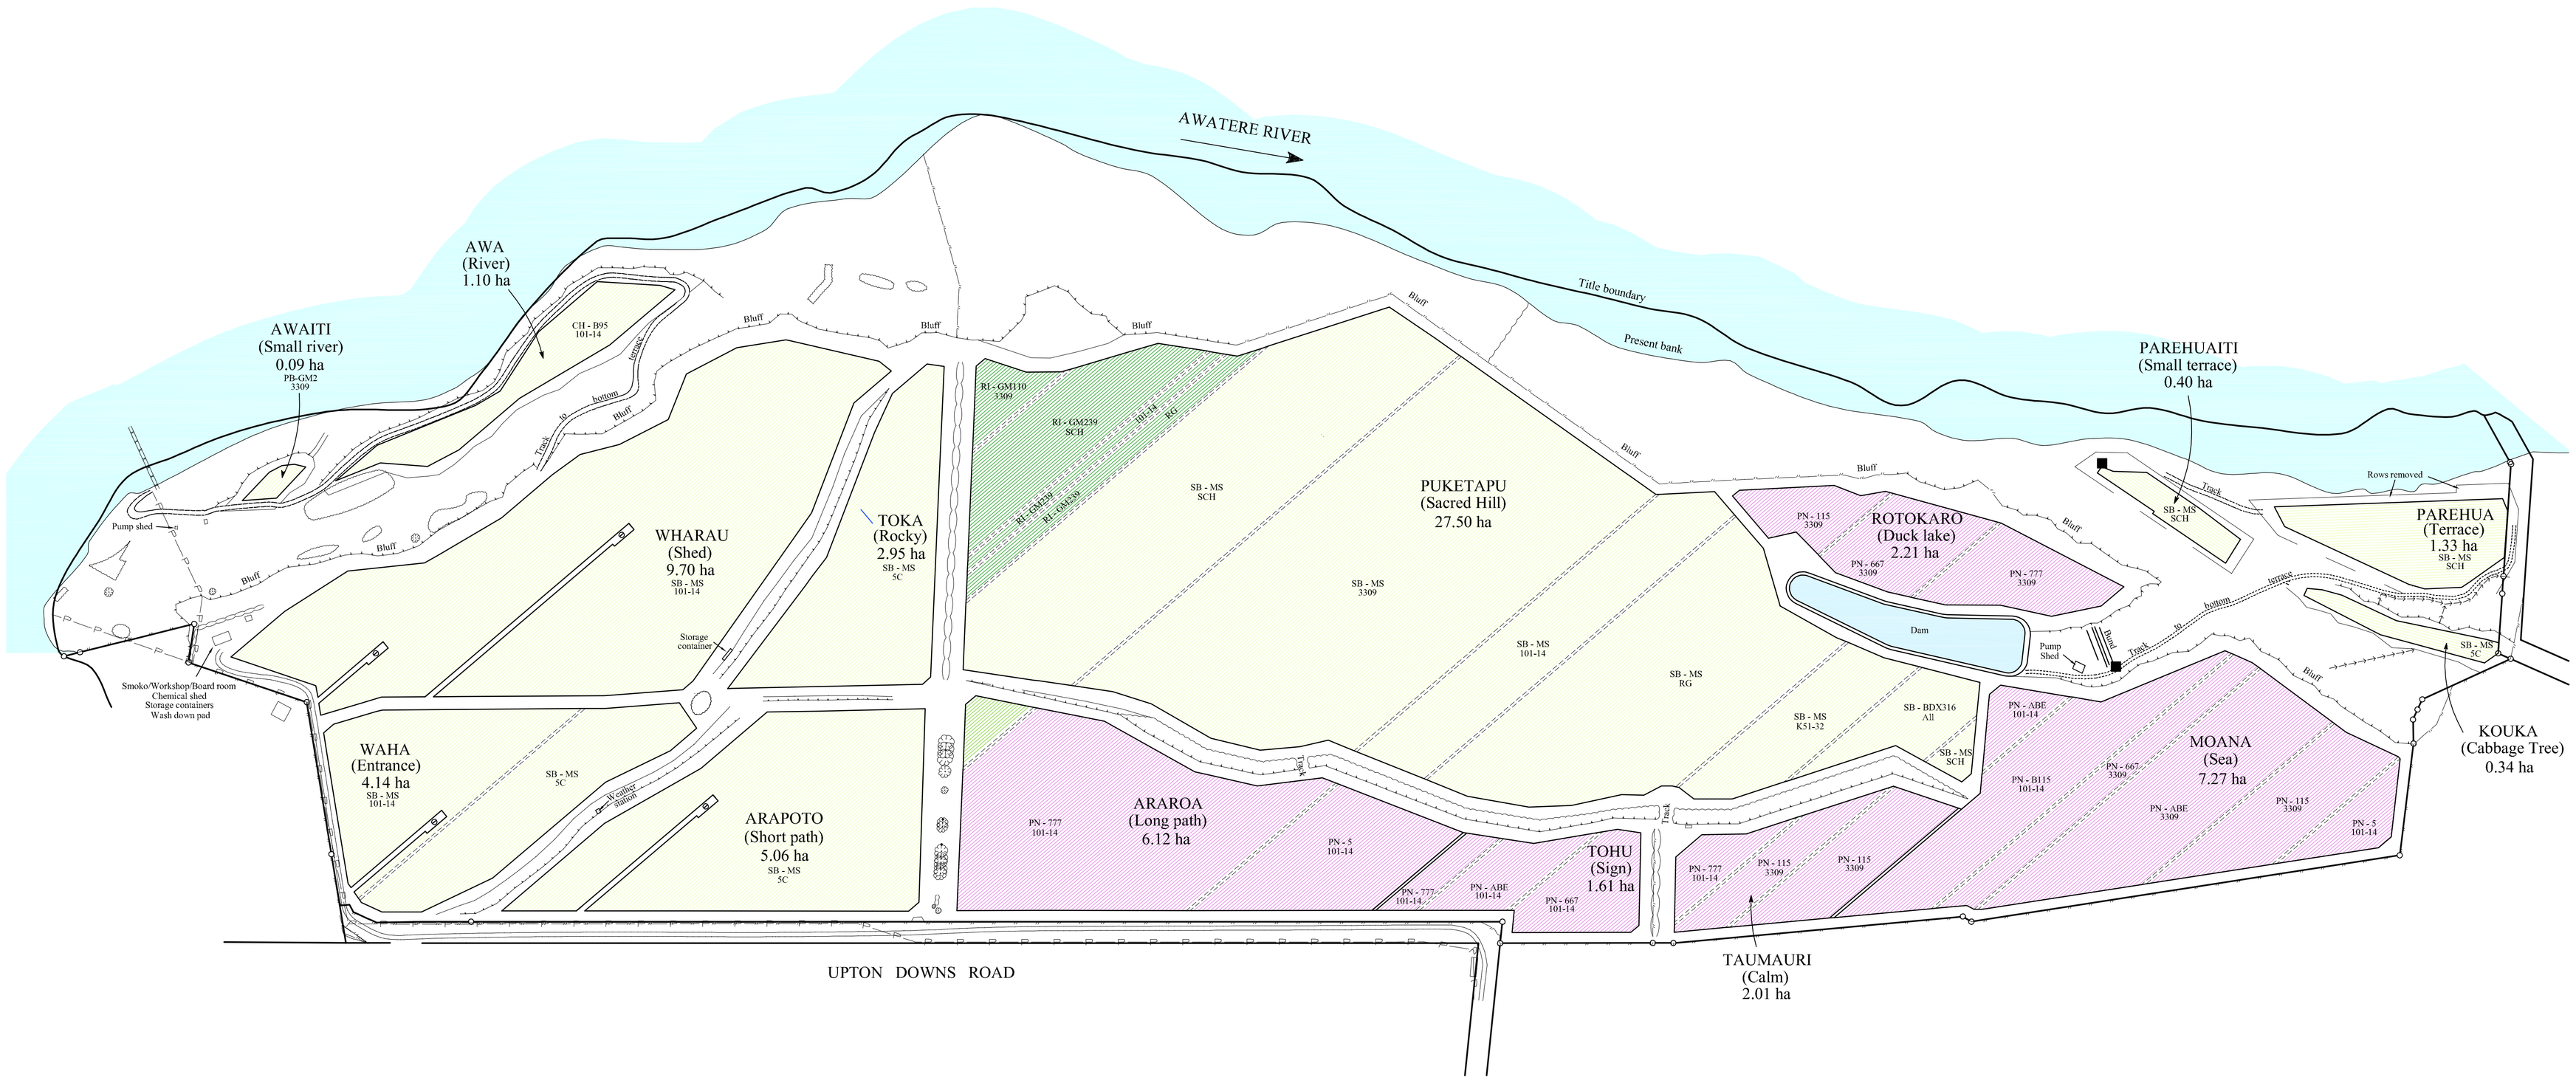
AWATERE RIVER
Title boundary
Present bank
AWA
(River)
1.10 ha
CH - B95
101-14
AWAITI
(Small river)
0.09 ha
PB-GM2
3309
Track to bottom terrace
Bluff
Pump shed
Smoko/Workshop/Board room
Chemical shed
Storage containers
Wash down pad
WHARAU
(Shed)
9.70 ha
SB - MS
101-14
Storage container
TOKA
(Rocky)
2.95 ha
SB - MS
5C
RI - GM310
3309
RI - GM239
SCH
101-54
RG
RI - GM239
RI - GM239
SB - MS
SCH
SB - MS
3309
PUKETAPU
(Sacred Hill)
27.50 ha
SB - MS
101-14
SB - MS
RG
SB - MS
K51-32
SB - BDX316
All
SB - MS
SCH
PN - 115
3309
ROTOKARO
(Duck lake)
2.21 ha
PN - 667
3309
PN - 777
3309
Dam
Pump Shed
Track
Band
PAREHUAITI
(Small terrace)
0.40 ha
SB - MS
SCH
Track
Rows removed
PAREHUA
(Terrace)
1.33 ha
SB - MS
SCH
SB - MS
5C
KOUKA
(Cabbage Tree)
0.34 ha
WAHA
(Entrance)
4.14 ha
SB - MS
101-14
SB - MS
5C
Weather station
ARAPOTO
(Short path)
5.06 ha
SB - MS
5C
ARAROA
(Long path)
6.12 ha
PN - 777
101-14
PN - 5
101-14
PN - 777
101-14
PN - ABE
101-14
PN - 667
101-14
TOHU
(Sign)
1.61 ha
PN - 777
101-14
PN - 115
3309
PN - 115
3309
TAUMAURI
(Calm)
2.01 ha
PN - ABE
101-14
PN - B115
101-14
PN - 667
3309
PN - ABE
3309
PN - 115
3309
PN - 5
101-14
MOANA
(Sea)
7.27 ha
UPTON DOWNS ROAD